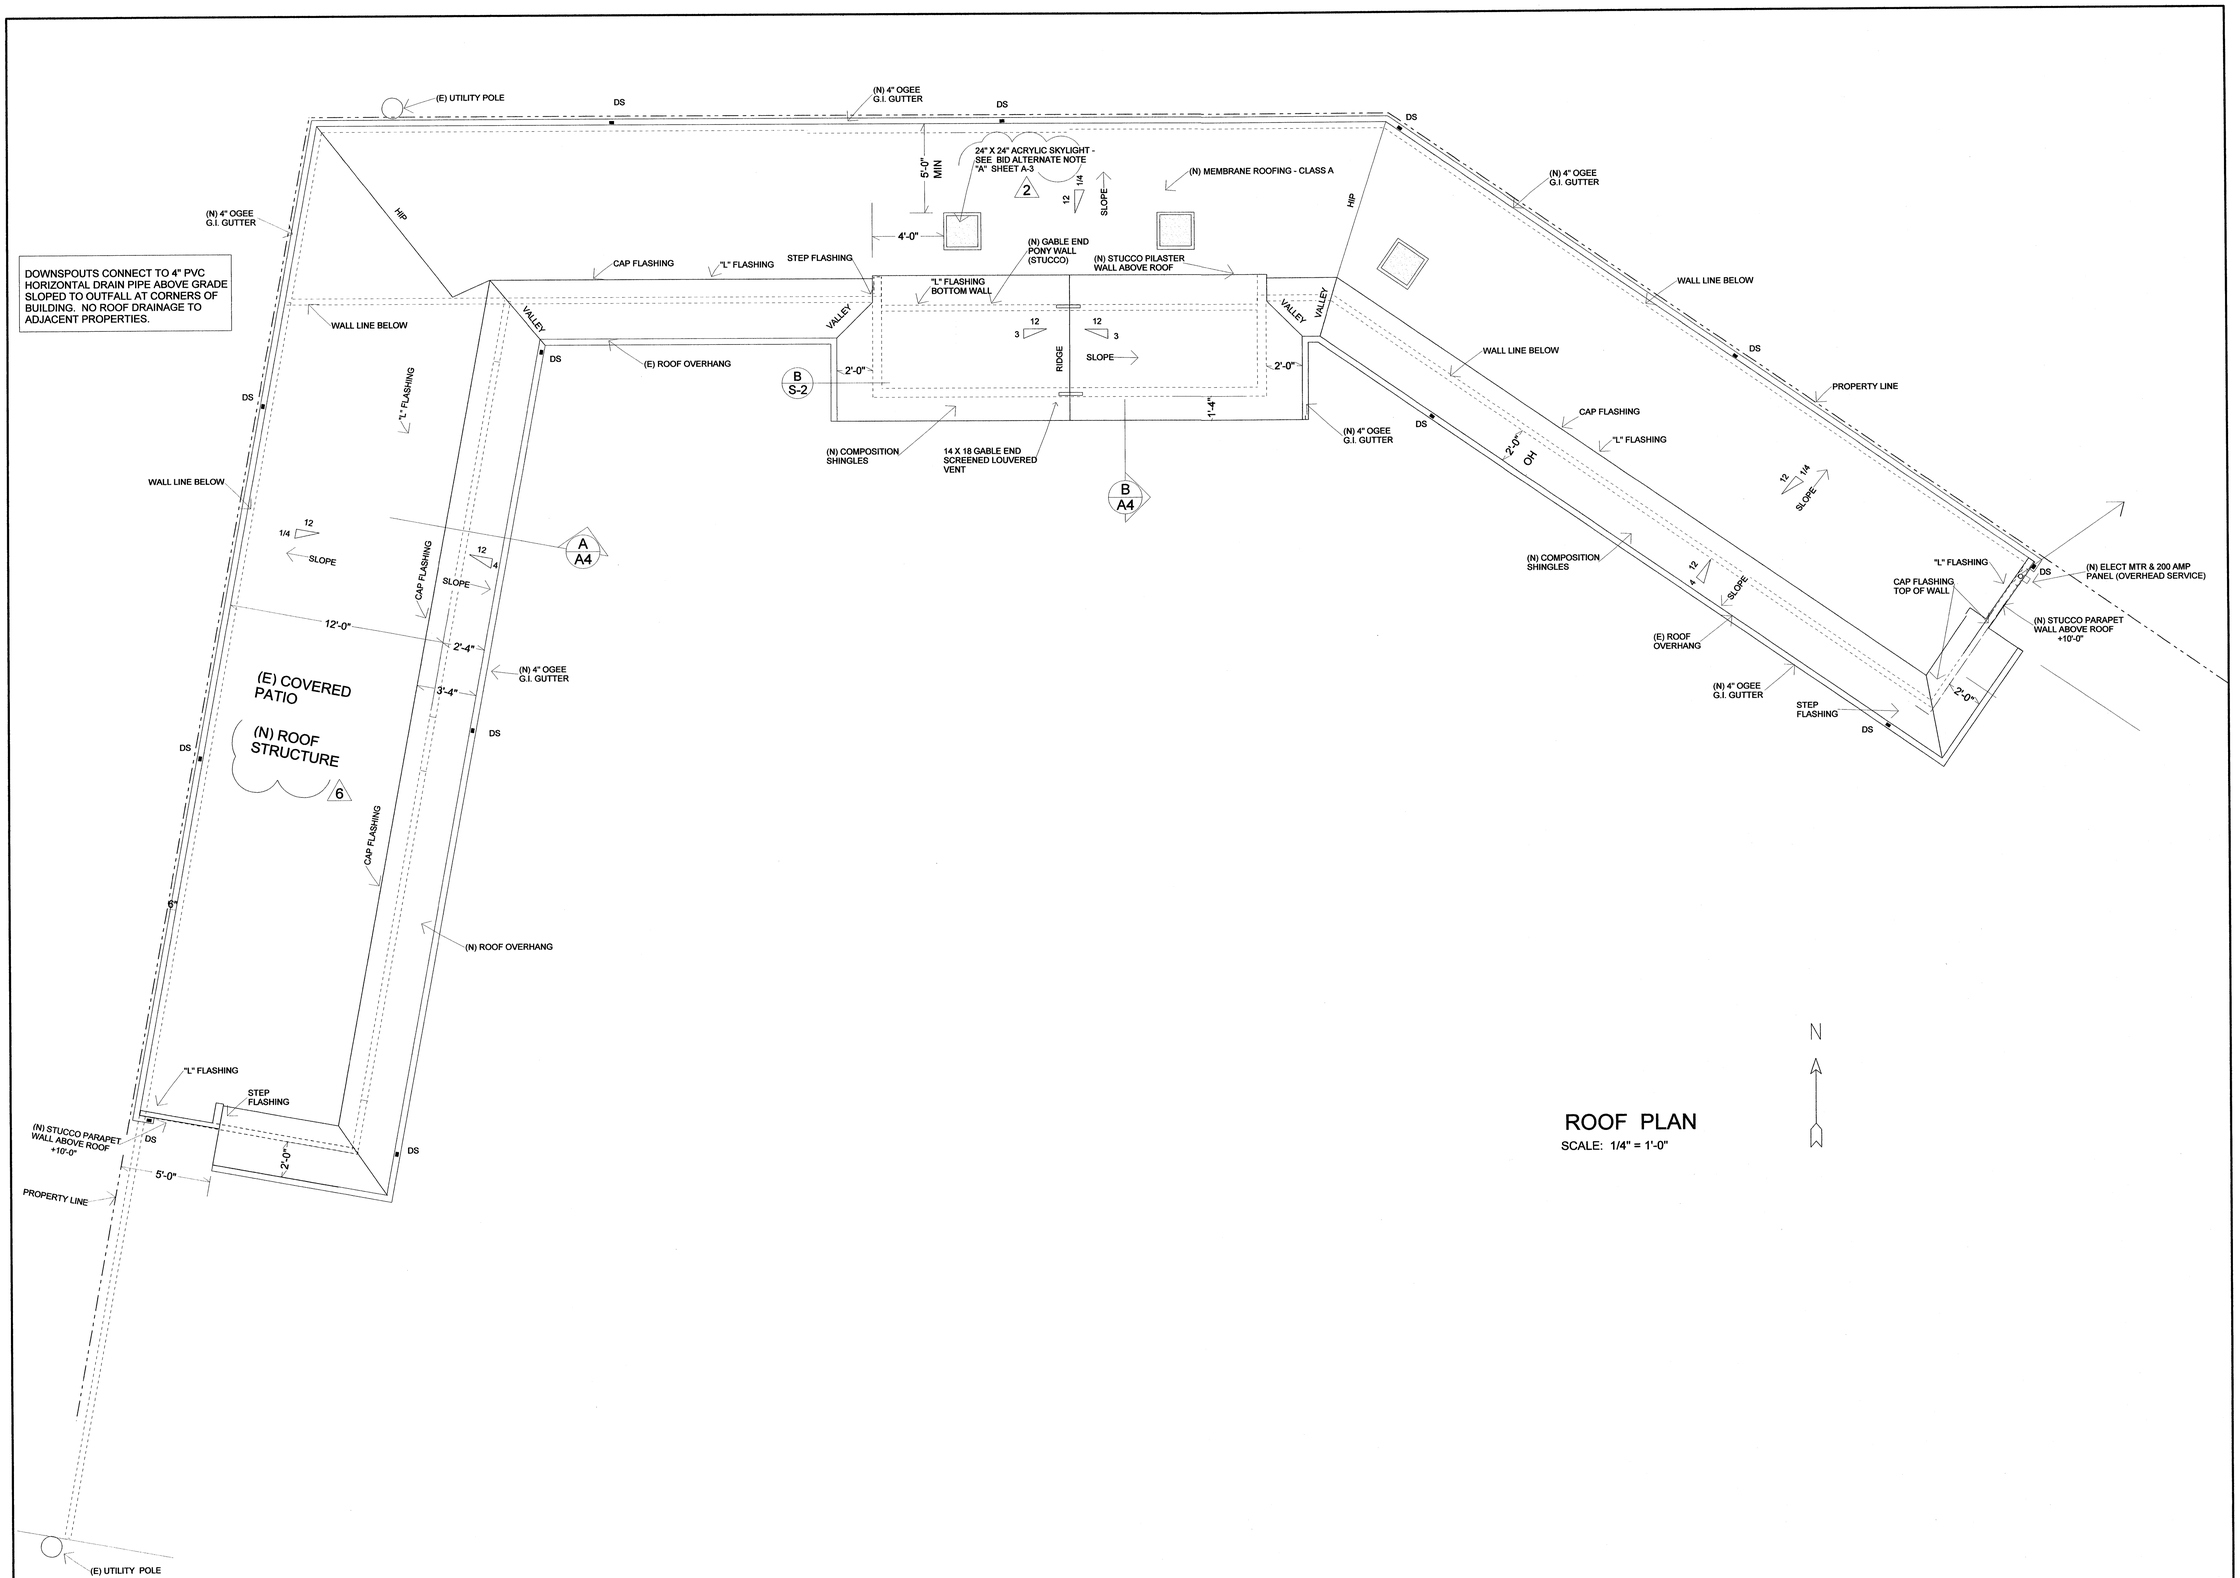

ROOF PLAN

SCALE: 1/4" = 1'-0"

REVISIONS		BY
1	COUNTY HEALTH PLAN REVIEW	JDM 4/4/11
2	OWNER REVISIONS COVERED PATIO	JDM 5/24/11

The plans, ideas, arrangements and designs indicated or represented by these drawings are owned by, and are the property of the Architect and were developed solely for use on this project and shall not be used, in whole or in part, for any purpose for which they were not originally intended without written permission from JIM D. MORELAN, A.I.A. ARCHITECT

MORELAN ASSOCIATES, INC. ARCHITECTURE CONSTRUCTION
JIM D. MORELAN, A.I.A. - ARCHITECT- C-5471
1101 S. WINCHESTER BLVD. - SUITE G-181 - SAN JOSE, CALIFORNIA 95128-3917
TEL. (408) 247-3322 FAX. (408) 247-5560

LICENSED ARCHITECT JIM D. MORELAN No. C-5471 Ren. 12/11 STATE OF CALIFORNIA

ROOF PLAN & DETAILS

POOL HOUSE RESTROOM REMODEL & ADDITION
LOS RANCHITOS CABANA CLUB
1601 LA PRADERA DRIVE - CAMPBELL, CA 95008

DRAWN	JDM
DATE	02/06/2011
SCALE	AS NOTED
JOB NO.	2010.31
SHEET	A-6
OF	11 SHEETS

COUNTY ENIORNMENTAL HEALTH REVIEW 02/10/2011 (REVISION 04/04/2011)
CITY CAMPBELL PLAN REVIEW
OWNER REVISION 05/24/2011 - 7/13/11